




Captive Audio, Ltd
9401 Burnet Road

Austin, TX 78758
(512) 997-9001
(512) 997-9003

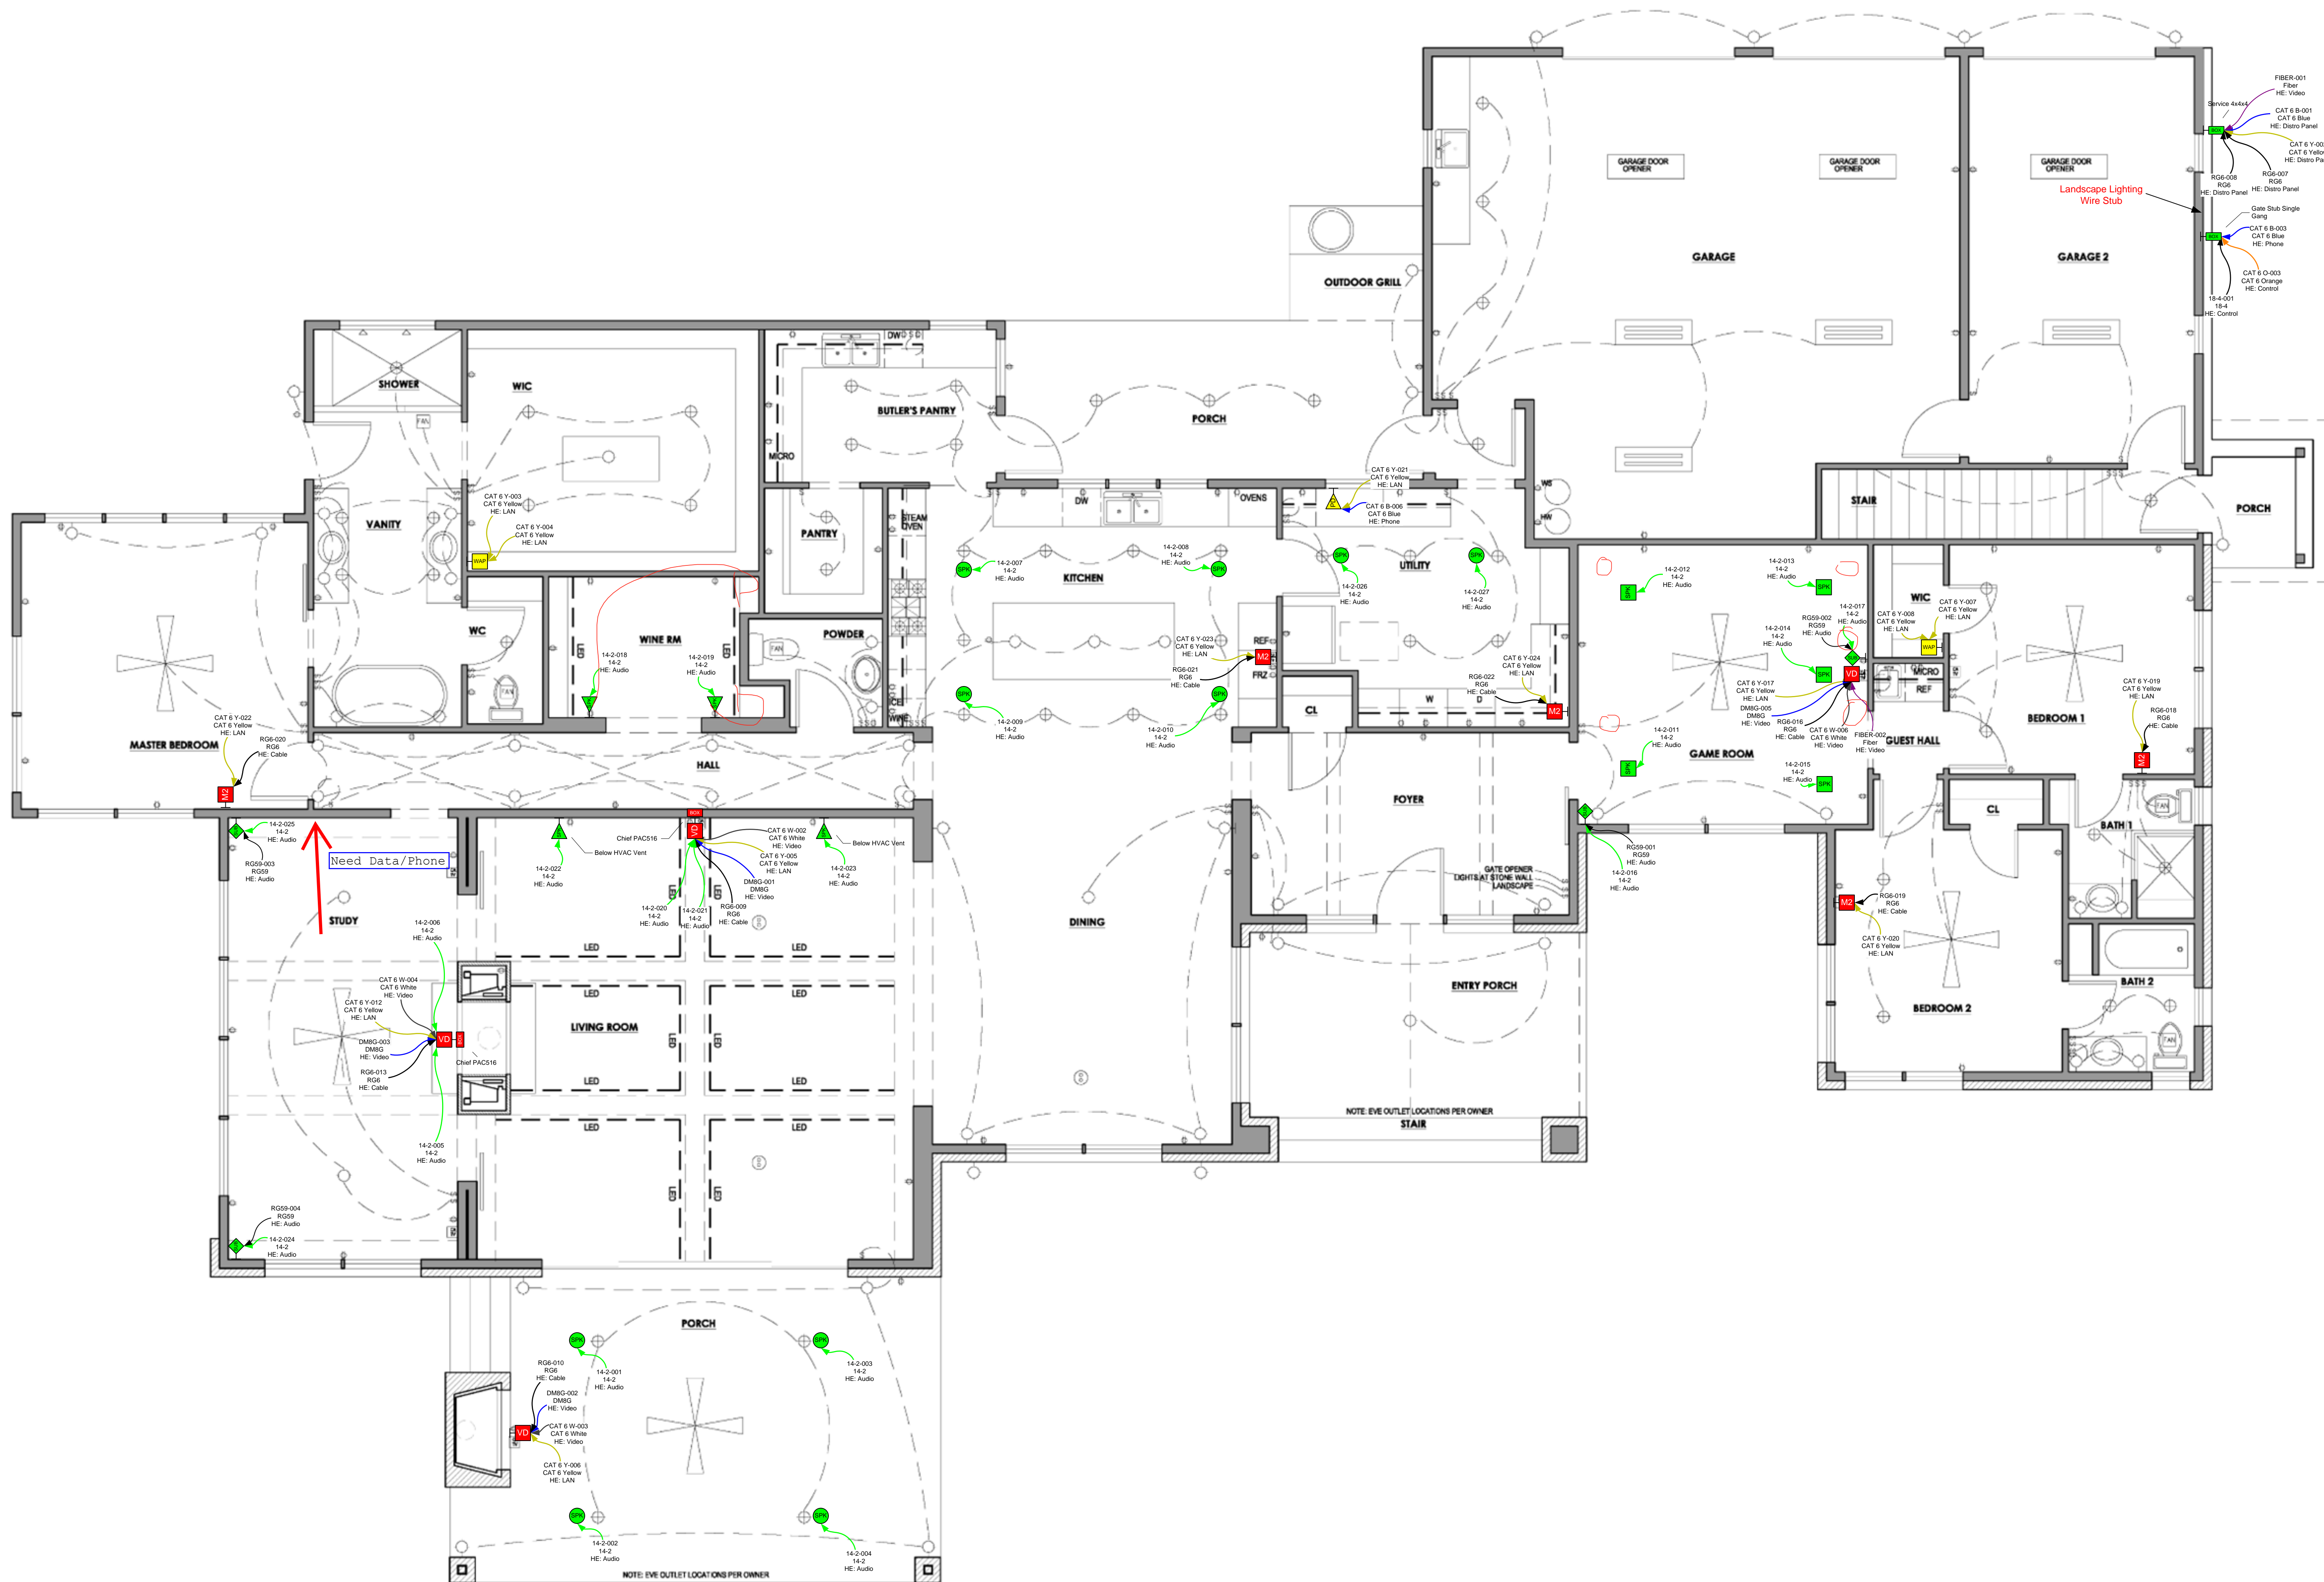

Dates:
Created - 10/28/2013
Modified - 10/28/2014
Printed - 11/3/2014

Mulcahy Bass Residence
Watermark Homes
1330 Ranchers Club Lane
Driftwood, TX

Low Voltage Wiring Plan
First Floor

