

ORDERED BY:



3708 Spicewood Springs Rd. • Suite 100 • Austin, Texas 78759  
p: 512-346-4020 • f: 512-651-9246  
www.austintitle.com

POWERED BY

**STARS**  
SURVEY TRACKING  
AND  
RETRIEVAL SYSTEM  
www.surveystars.com



PROPERTY ADDRESS: 106 CONFIDENCE COVE LAKEWAY, TEXAS 78634

SURVEY NUMBER: 1703.4674


FIELD WORK DATE: 4/4/2017

REVISION DATE(S): (REV.1 4/4/2017)

**17034674**  
**BOUNDARY SURVEY**  
**TRAVIS COUNTY**

TABLE:  
LI N 20°06' E 8.69' (P)  
N 20°01'43" E 8.55' (M)

C-1  
R= 50.00'(P#M)  
L= 33.65'(P) 33.18'(M)  
Δ = 38°33'43"(P) 38°01'04"(M)  
S 14°14'00" E, 33.02'(P)  
S 13°59'08" E, 32.57'(M)

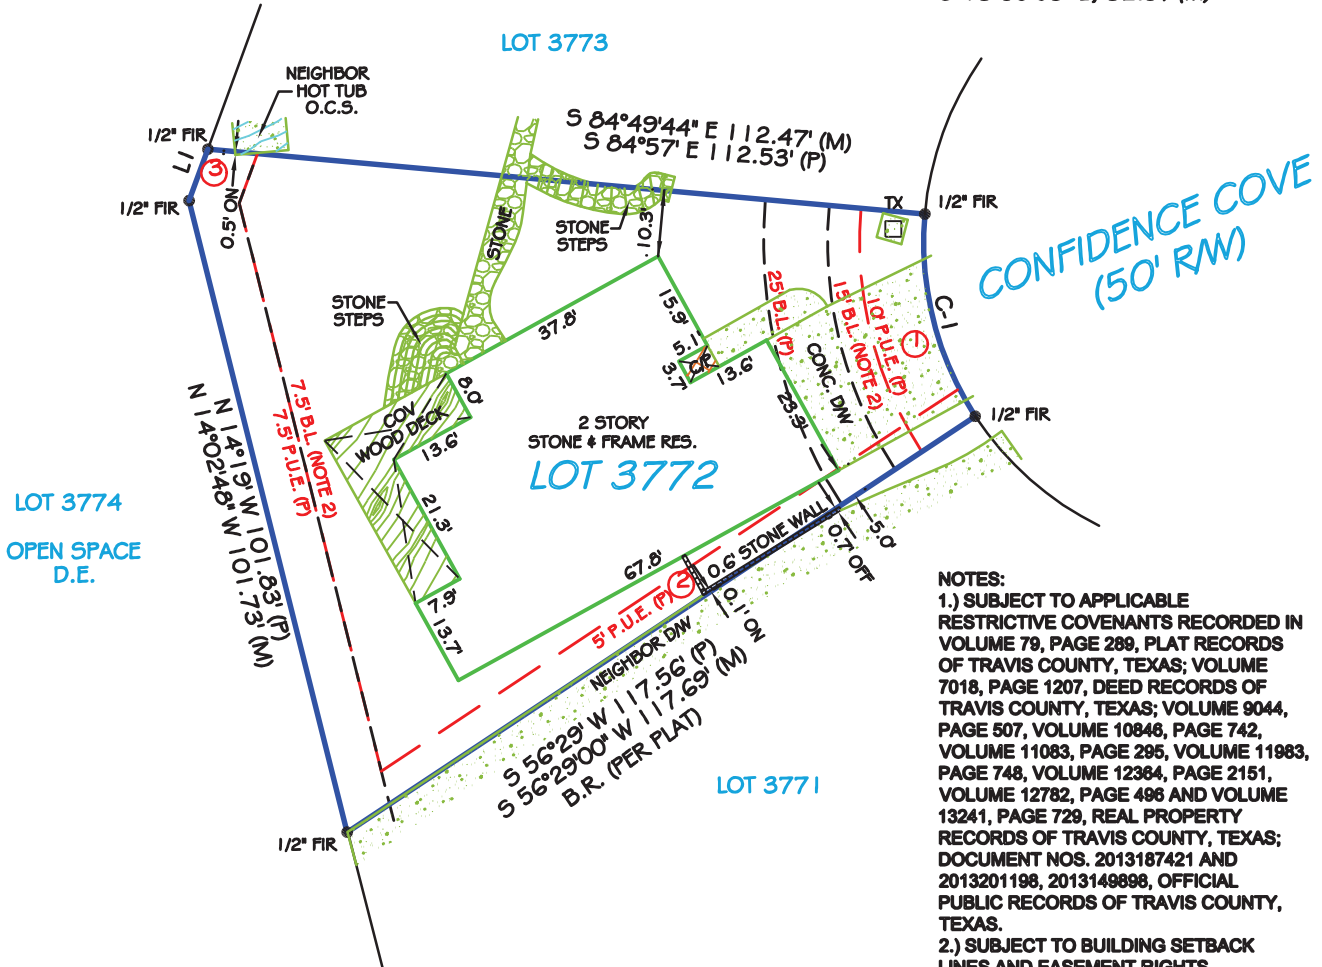


**NOTES:**  
1.) SUBJECT TO APPLICABLE RESTRICTIVE COVENANTS RECORDED IN VOLUME 79, PAGE 289, PLAT RECORDS OF TRAVIS COUNTY, TEXAS; VOLUME 7018, PAGE 1207, DEED RECORDS OF TRAVIS COUNTY, TEXAS; VOLUME 9044, PAGE 507, VOLUME 10846, PAGE 742, VOLUME 11083, PAGE 295, VOLUME 11983, PAGE 748, VOLUME 12364, PAGE 2151, VOLUME 12782, PAGE 498 AND VOLUME 13241, PAGE 729, REAL PROPERTY RECORDS OF TRAVIS COUNTY, TEXAS; DOCUMENT NOS. 2013187421 AND 2013201198, 2013149898, OFFICIAL PUBLIC RECORDS OF TRAVIS COUNTY, TEXAS.  
2.) SUBJECT TO BUILDING SETBACK LINES AND EASEMENT RIGHTS RECORDED IN VOL. 7018, PG. 1207 AND VOL. 11983, PG. 748, REAL PROPERTY RECORDS OF TRAVIS COUNTY, TEXAS.  
**NOTE:**  
**P.U.E. = PUBLIC UTILITY EASEMENT**



*Paul M. Valentine*

I HEREBY CERTIFY THAT: THIS PLAT REPRESENTS THE RESULTS OF A SURVEY MADE ON THE GROUND ON THE 4th DAY OF APRIL 2017; ALL EASEMENTS AND RIGHTS-OF-WAY SHOWN ON THE PLAT AND SET FORTH WITHIN THE TITLE COMMITMENT ISSUED BY FIDELITY NATIONAL TITLE INSURANCE COMPANY, GF NO. AUT-13-671-AUT17002708SG, EFFECTIVE MARCH 15, 2017, ARE SHOWN OR NOTED HEREON; THERE ARE NO VISIBLE ENCROACHMENTS OR OVERLAPPING OF IMPROVEMENTS EXCEPT AS SHOWN HEREON; THE PROPERTY HAS ACCESS TO A DEDICATED RIGHT-OF-WAY PER PLAT.

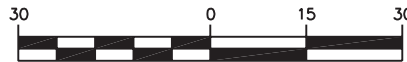

GRAPHIC SCALE (In Feet)  
1 inch = 30' ft.



Use of This Survey for Purposes other than Intended, Without Written Verification, will be at the User's Sole Risk and Without Liability to the Surveyor. Nothing hereon shall be Construed to Give ANY Rights or Benefits to Anyone Other than those Certified.

**FLOOD INFORMATION:**

BY PERFORMING A SEARCH WITH THE LOCAL GOVERNING MUNICIPALITY OR WWW.FEMA.GOV, THE PROPERTY APPEARS TO BE LOCATED IN ZONE X. THIS PROPERTY WAS FOUND IN THE CITY OF LAKEWAY, COMMUNITY NUMBER 481303, DATED 09/26/08.

**POINTS OF INTEREST:**

1. CONCRETE DRIVEWAY OVER 10' PUBLIC UTILITY EASEMENT 2. 0.6' STONE WALL OVER 5' PUBLIC UTILITY EASEMENT 3. NEIGHBORING LOT'S HOT TUB DECK OVER 7.5' PUBLIC UTILITY EASEMENT AND LOT LINE

CLIENT NUMBER:

DATE: 4/4/2017

BUYER: HEATH HALE

SELLER: TODD RIESTERER AND AMY RIESTERER

CERTIFIED TO: HEATH HALE; AUSTIN TITLE; FIDELITY NATIONAL TITLE INSURANCE COMPANY; CROSSCOUNTRY MORTGAGE INC.

This is page 1 of 2 and is not valid without all pages.

POWERED BY:



www.surveystars.com

**EXACTA**  
TEXAS SURVEYORS, INC.

LB# 10193731  
exacta365.com  
p: 866.735.1916  
f: 866.744.2882

7416 Canal Drive, Lake Worth, FL 33467

**LEGAL DESCRIPTION:**

LOT 3772, LAKEWAY SECTION CLUSTERS 28 V, AN ADDITION IN TRAVIS COUNTY, TEXAS, ACCORDING TO THE MAP OR PLAT OF RECORD IN VOLUME 79, PAGE 289, PLAT RECORDS OF TRAVIS COUNTY, TEXAS.

**JOB SPECIFIC SURVEYOR NOTES:**

THE BEARING REFERENCE OF SOUTH 56 DEGREES 29 MINUTES WEST IS BASED ON THE SOUTHEASTERLY LINE OF LOT 3772, OF LAKEWAY SECTION CLUSTERS 28 V, ACCORDING TO THE PLAT THEREOF, AS RECORDED IN VOLUME 79, PAGE 289 OF THE PLAT RECORDS OF TRAVIS COUNTY, TEXAS.

**GENERAL SURVEYOR NOTES:**

1. Firm Branch #10193731 is physically located at 7416 Canal Drive in Lake Worth, FL 33467.
2. The Legal description used to perform this survey was supplied by others. This survey does not determine or imply ownership.
3. Due to varying construction standards, house dimensions are approximate.
4. This survey is exclusively for the use of the parties to whom it is certified. It is not transferable to additional institutions or subsequent owners.
5. This property subject to any and all recorded and unrecorded easements. Surveyor has made no investigation or independent search for easements of record, encumbrances, restrictive covenants or ownership title evidence.
6. If there is a septic tank, well or drain field on this survey, the location of such items was shown to us by others and are not verified.
7. Any additions or deletions of this 2 page survey document are strictly prohibited. Use of this survey beyond the purpose of the transfer of title without written authorization of the signing surveyor is prohibited.
8. Any FEMA flood zone data contained on this survey is for informational purposes only. Research to obtain such data was performed at www.fema.gov.
9. Dimensions are in feet and decimals thereof.
10. All pins marked as set are 5/8" or 1/2" diameter, 18" iron rebar, with "EXACTA" cap.
11. This survey only shows improvements found above ground. Underground footings, utilities and encroachments are not located on this survey map.
12. The information contained on this survey has been performed exclusively, and is the sole responsibility, of Exacta Surveyors. Additional logos or references to third party firms are for informational purposes only.
13. Points of Interest (POI's) are selected above- ground improvements which may be in contact with boundary, building setbacks or easement lines, as defined by the parameters of this survey. There may be additional POI's which are not shown, not called-out as POI's, or which are otherwise unknown to the surveyor. These POI's may not represent all items of interest to the viewer.
14. Utilities shown on the subject property may or may not indicate the existence of recorded or unrecorded utility easements.
15. House measurements should not be used for new construction or planning. Measurements should be verified prior to such activity.

**LEGEND:**

**SURVEYOR'S LEGEND**

|   |  |   |  |   |  |
|---|--|---|--|---|--|
| <b>LINETYPES: ( UNLESS OTHERWISE NOTED)</b> |  | <b>SURFACE TYPES: ( UNLESS OTHERWISE NOTED)</b> |  | <b>SYMBOLS: ( UNLESS OTHERWISE NOTED)</b> |  |
|   | BOUNDARY LINE                          |   | ASPHALT                                |   | BENCH MARK                             |
|   | STRUCTURE                              |   | BRICK or TILE                          |   | CENTERLINE                             |
|   | CENTERLINE                             |   | COVERED AREA                           |   | CENTRAL ANGLE or DELTA                 |
|   | CHAIN LINK or WIRE FENCE               |   | WATER                                  |   | COMMON OWNERSHIP                       |
|   | EASEMENT                               |   | WOOD                                   |   | CONTROL POINT                          |
|   | EDGE OF WATER                          |   | WOODEN FENCE                           |   | CONCRETE MONUMENT                      |
| <b>A/C</b>                                  | AIR CONDITIONING                       |   | TREE                                   |   | UTILITY OR LIGHT POLE                  |
| <b>B.R.</b>                                 | BEARING REFERENCE                      |   | WELL                                   |   | WELL                                   |
|   |  |   |  |   |  |